

凡 例	
●	プレート
●	プレート
●	コンクリート杭
●	既設標示等

# 距離・方向角の計算書

世界測地系



現場名：出来形確認測量

平成 19 年 6 月 6 日

縮尺係数  
辺の総合計

0.999938  
177.259m

No	点番	器械点名	X	点番	視準点名	X	平面距離	方向角
			Y			Y		
1	347	G9-5	-150854.899	350	G9-32	-150854.655	16.078	270° 52' 10"
			-55188.555			-55204.631	16.079	
2	348	G9-6	-150856.147	349	G9-31	-150855.898	16.079	270° 53' 14"
			-55188.576			-55204.653	16.080	
3	353	G9-7	-150866.970	356	G9-30	-150866.724	16.094	270° 52' 33"
			-55188.728			-55204.820	16.095	
4	354	G9-8	-150869.025	355	G9-29	-150868.779	16.100	270° 52' 32"
			-55188.759			-55204.857	16.101	
5	357	G9-9	-150881.285	364	G9-28	-150881.042	16.111	270° 51' 51"
			-55188.943			-55205.052	16.112	
6	358	G9-10	-150893.541	363	G9-27	-150893.298	16.119	270° 51' 50"
			-55189.129			-55205.246	16.120	
7	359	G9-11	-150901.955	362	G9-26	-150901.713	16.125	270° 51' 36"
			-55189.252			-55205.375	16.126	
8	360	G9-12	-150905.792	361	G9-25	-150905.549	16.128	270° 51' 48"
			-55189.313			-55205.439	16.129	
9	371	G9-13	-150919.981	375	G9-24	-150919.733	16.145	270° 52' 49"
			-55189.520			-55205.663	16.146	
10	372	G9-14	-150923.312	374	G9-23	-150923.064	16.146	270° 52' 48"
			-55189.573			-55205.717	16.147	
11	376	G9-16	-150929.327	373	G9-21	-150929.084	16.123	270° 51' 49"
			-55189.659			-55205.780	16.124	

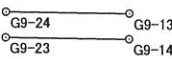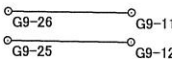

## 面積集計表

平成 19 年 6 月 6 日

現場名：出来形確認測量


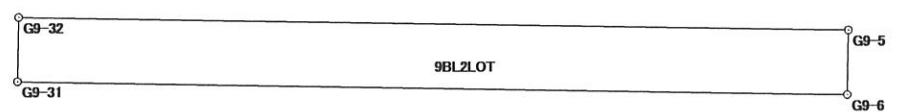
所有者	No.	地番No	地番名	面積	地積	坪数
	1	98	9BL1LOT	285.2128610	285.21	86.27
	2	99	9BL2LOT	20.0285805	20.02	6.05
	3	100	9BL3LOT	174.1461465	174.14	52.67
	4	104	9BL4LOT	135.6722950	135.67	41.04
	5	105	9BL5LOT	61.8768005	61.87	18.71
	6	106	9BL6LOT	228.9449895	228.94	69.25
	7	107	9BL7LOT	53.7872665	53.78	16.27
	8	108	9BL8LOT	97.1240665	97.12	29.38
	9	109	9BL9LOT	166.8787650	166.87	50.48
	10	101	9BL10LOT	33.0835890	33.08	10.00
	11	102	9BL11LOT	197.4993980	197.49	59.74
	12	103	9BL12LOT	197.5270980	197.52	59.75
合計			12筆	1651.7818560	1651.71	499.61



# 座 標 面 積 計 算 書

世界測地系

地番	9BL2LOT	地目	
----	---------	----	--

境界点	X 座標	Y 座標	辺長	方向角	備考	
G9-5	-150854.899	-55188.555	1.248	180° 57' 50"		<div style="text-align: right; margin-bottom: 20px;">  </div> <div style="text-align: center;">  </div>
G9-6	-150856.147	-55188.576	16.079	270° 53' 14"		
G9-31	-150855.898	-55204.653	1.243	1° 00' 50"		
G9-32	-150854.655	-55204.631	16.078	90° 52' 10"		

面積算出公式		面 積	20.0285805	土地の所在	清音上中島1811番2
$A = \frac{1}{2} \sum X_n \times (Y_{n+1} - Y_{n-1})$		地 積	20.02	土地の所有者	



# 座 標 面 積 計 算 書

世界測地系

地番	9BL4LOT	地目	
----	---------	----	--

境界点	X 座標	Y 座標	辺長	方向角	備考	
G9-10	-150893.541	-55189.129	8.415	180° 50' 15"		<div style="text-align: right; margin-bottom: 10px;"> </div>
G9-11	-150901.955	-55189.252	16.125	270° 51' 36"		
G9-26	-150901.713	-55205.375	8.416	0° 52' 42"		
G9-27	-150893.298	-55205.246	16.119	90° 51' 50"		
面積算出公式		面積	135.6722950		土地の所在	清音上中島1811番7
$A = \frac{1}{2} \sum X_n \times (Y_{n+1} - Y_{n-1})$		地積	135.67		土地の所有者	








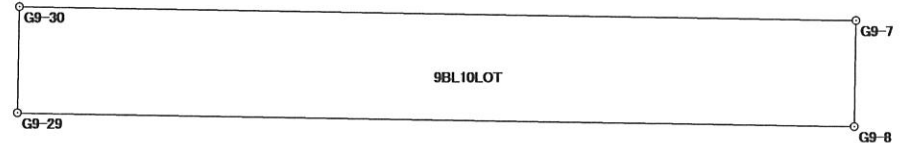




# 座 標 面 積 計 算 書

世界測地系

地番	9BL10LOT	地目	
----	----------	----	--

境界点	X 座標	Y 座標	辺長	方向角	備考	
G9-7	-150866.970	-55188.728	2.055	180° 51' 51"		<div style="text-align: right; margin-bottom: 20px;">  </div> 
G9-8	-150869.025	-55188.759	16.100	270° 52' 32"		
G9-29	-150868.779	-55204.857	2.055	1° 01' 53"		
G9-30	-150866.724	-55204.820	16.094	90° 52' 33"		
面積算出公式		面積	33.0835890		土地の所在	
$A = \frac{1}{2} \sum X_n \times (Y_{n+1} - Y_{n-1})$		地積	33.08		土地の所有者	





